


AREA: MVT-E	GRID SQUARE (S): 101-M22	GRID CO-ORDINATES: E N	INITIALS & DATE: MAAG - MAR A22 31 I 2012	FEATURE No.: [33117]									
FEATURE TYPE (For example wall, staircase, bench, foundation structure, platform etc.): Accretion wall			Full extent visible in plan: YES / NO <input checked="" type="checkbox"/> YES / <input type="checkbox"/> NO										
1. Dimensions (in metres)		Length: 3.22M	Width: 0.14M	Height: 0.21M									
2. Type of material(s) used		Mud Brick											
3. Coursing (form of construction)		Two coursing stretch											
4. Orientation		North - South											
5. Associated collapse		32768											
6. Cut & fill feature #'s		—											
7. Repaired?		—											
8. Associated floors		—											
9. Surface treatments? E.g. plaster, paint, mouldings		—											
10. Size of one component		0.29M x 0.14M width x 0.09M height											
11. Bonding material		Sandy silt											
12. Excavated		Yes/No <input checked="" type="checkbox"/> Yes											
Mini stratigraphic matrix		Abuts: (32863) Same as:											
<table border="1"> <tr> <td></td> <td>33114</td> <td></td> </tr> <tr> <td></td> <td>33117</td> <td></td> </tr> <tr> <td></td> <td>33118</td> <td></td> </tr> </table>			33114			33117			33118		Abutted by: <33114> + Associated features: Bonded into: <del>32863</del> 33118 = FOUNDATION MATERIAL. Contiguous with: ( <del>32863</del> )		
	33114												
	33117												
	33118												
Discussion and interpretation:													
accretion wall to save wall (32863) in the bottom  — PART OF LATER SETTLEMENT, CONST AS PART OF WORKS TO FIRM SPACES 203 → 205 (CHASSIS) / GPMP SPACES 11704 → 11706 — DEFINES W. LIMIT OF SPACE 205/11706													


J. 12.12.

Remember: do not just draw the architectural feature in isolation. Show how it relates to surrounding features and include details of surface treatments, repairs/modifications/damage, bonding material(s), and associated cuts. Annotate all aspects of the feature or use a Drawing Key. Measurements must be included for all aspects of the feature and surrounding features.

Sketch Plan - Include grid co-ordinates, North arrow, and elevations.

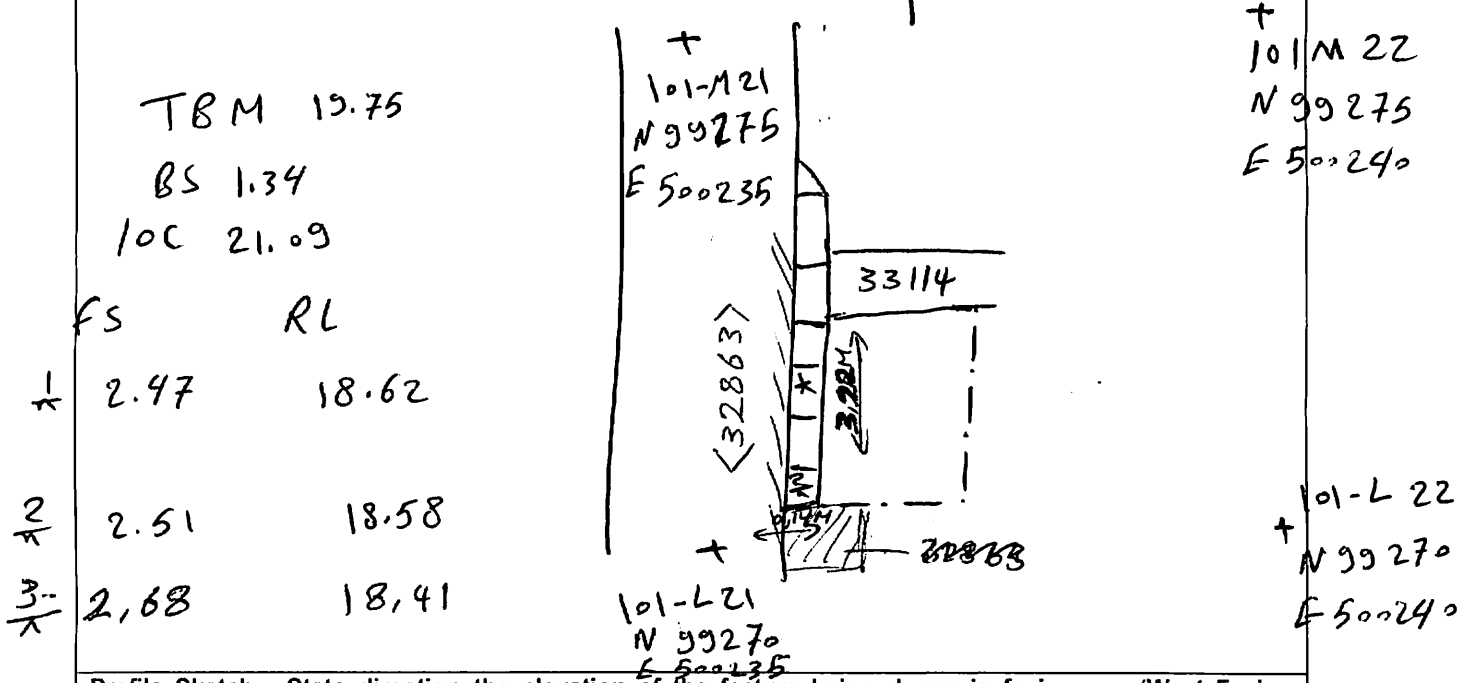

Profile Sketch - State direction the elevation of the feature being drawn is facing e.g. 'West Facing Elevation of Feature .... If feature was drawn in section then include the grid co-ordinates and elevations.

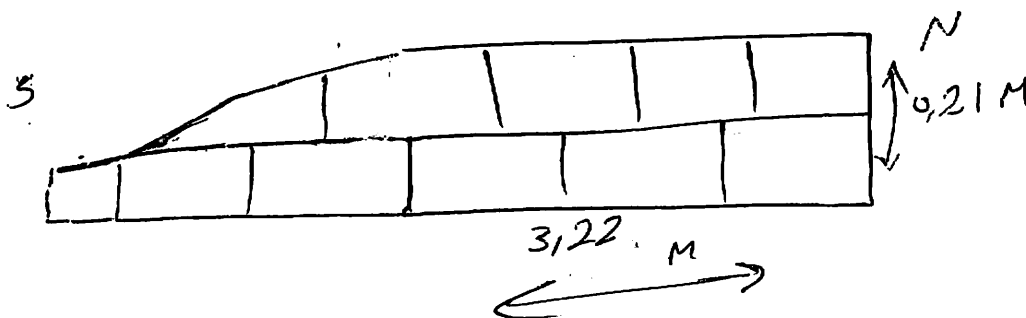

Drawing No.'s:	C33117 + 2012-41	Photo No.'s:	512586, 512587, 512588, 512589
Space No.:	11206	Structure No.:	
Matrix Group:		Matrix Phase:	
Samples taken:	2012-598		