
		RDINATES:	_	INITIALS & DAT	ΓE:	FEATURE No.:
CKT-E+ J 45, 46, 47 E			AKOA		77262	
J 45, 46, 42 N			AKOA 4 March 212 33262			
FEATURE TYPE (For example wall,	htairanaa	hanah faund	-11	Full extent visil		loni
structure, platform etc.):	plaircase, i	bench, lound	auon	ruli extent visii	oie iu b	ian.
				YI	ES / 1	NO
1. Dimensions (in metres)	Length:		Width		Heigh	t:
,	16,	<b>1</b> 1	2	2.20m 0.50m		i
2. Type of material(s) used	+					
Type of materially asca						
3. Coursing (form of construction)				_ · _ <del>_ ·</del>		-
4. Orientation	$\epsilon$	195+-u	est	**		
5. Associated collapse						
6. Cut & fill feature #'s						
,			_			
7. Repaired?						
8. Associated floors						
9. Surface treatments? E.g. plaster,					_	
paint, mouldings						
10. Size of one component				<del></del>		
11. Bonding material		·				
12. Excavated	Yes/No					
				Same a		
Mini stratigraphic matrix	1	Abuts: 33	423	Same	13.	Į.
Mini stratigraphic matrix  34 o 47 54 54 6	· 57		•			atures:
340 97 540	57	Abutted by:		Associ		atures:
	57					atures:
340 97 540	57	Abutted by:	<b>)</b> :			atures:
340 42 340	57	Abutted by:	<b>)</b> :			atures:
340 47 540 S40 MF E Discussion and interpretation:		Abutted by: Bonded into Contiguous	o: with:	Associ	ated fea	
340 47  33262  NFE  Discussion and interpretation:  - easT_wesT_ma	ussive n	Abutted by: Bonded into Contiguous	with:	Associ	en i la	oSure wall
340 47  33262  NFE  Discussion and interpretation:  - easT_wesT_ma	ussive n	Abutted by: Bonded into Contiguous	with:	Associ	en i la	oSure wall
340 47  33262  NFE  Discussion and interpretation:  - easT_wesT_ma  (33262) & F Silo buildin	ussive n	Abutted by: Bonded into Contiguous	with:	Associ	en i la	oSure wall
340 47  33262  NFE  Discussion and interpretation:  - easT_wesT_ma	ussive n	Abutted by: Bonded into Contiguous	with:	Associ	en i la	oSure wall
340 47  33262  NFE  Discussion and interpretation:  - easT_wesT_ma  (33262) & F Silo buildin	ussive n	Abutted by: Bonded into Contiguous	with:	Associ	en i la	oSure wall
340 47  33262  NFE  Discussion and interpretation:  - easT_wesT_ma  (33262) & F Silo buildin	ussive n	Abutted by: Bonded into Contiguous	with:	Associ	en i la	oSure wall
## ARCHITECTURE RECORDING FORM

Remember: do not just draw the architectural feature in isolation. Show how it relates to surrounding features and include details of surface treatments, repairs/modifications/damage, bonding material(s), and associated cuts. Annotate all aspects of the feature or use a Drawing Key. Measurements must be included for all aspects of the feature and surrounding features.

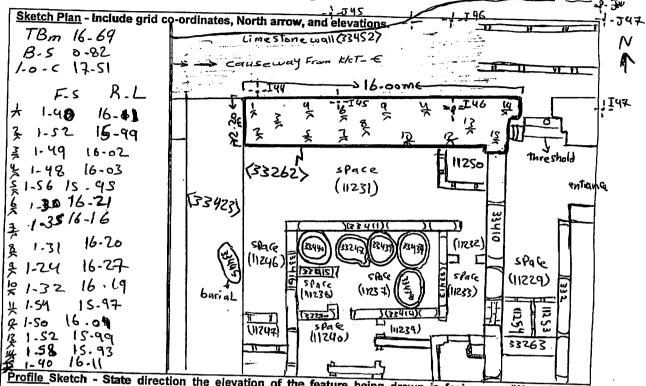

Profile Sketch - State direction the elevation of the feature being drawn is facing e.g. 'West Facing Elevation of Feature .... If feature was drawn in section then include the grid co-ordinates and elevations.

Drawing No.'s:	Photo No.'s:
Space No.: 11231 - 11250-	Structure No.:
Matrix Group:	Matrix Phase:
Samples taken:	madix Filase: