
AREA:	GRID SQUARE (S):	GRID CO-C	ORDINATES:		INITIALS & DA	TE:	FEATURE No.:	
KKTIN	201 E16 201 F16	E			HAHA		33320	
1,1,1,1,1,1	201 F 16	N			אחרוו		35320	
	YPE (For example wa	∐, staircase,	bench, found	ation	Full extent visi	ble in p	plan:	
structure, p	latform etc.):	1211			Y	ES) /	NO	
1. Dimensions (in metres)		Length:	Length: Width: Height:			nt:		
		2.5	so M	0.	40	0.20	o M	
2. Type of m	naterial(s) used	Mud	LBrick	,				
3. Coursing	(form of construction	one	one course headers of mud Brick					
4. Orientation			N-S					
5. Associated collapse					·		•	
6. Cut & fill f	feature #'s	-						
7. Repaired	?			<del></del> -				
8. Associate	d floors					_		
9. Surface tr paint, mould	eatments? E.g. plaste lings	r,						
10. Size of o	ne component	0.40	m x0.2	.0 M				
11. Bonding	material	san	ly sitt					
12. Excavate	ed	Yes/No	NOT ER	(CNVa	ction			
Mini stratigra	aphic matrix		Abuts: < 3	3326	Same a	as:		
	333 <b>‡9</b>		1		319 > Associa	ated fea	atures:	
	33320		Bonded into	:				
	73329		Contiguous	with:				
Discussion a	and interpretation:	<del></del>	<u> </u>					
itis au	vall of mudb	rick or	ne head	lers	COUNSES,	form	s The western	
walle	of the room 118	b, and +	he eastern	لصب	ll of the 1	(oom)	5 <b>  47</b> /9 <b>4</b> :+1/29	
it ab	outs the main	Norther	n wall a	f the	house , and	lab	uted by	
							j	
	. <u>4</u> + +	tin wall	is a n	rodit	fication ever	sh E	Becane	
14 13	clean that t	layor	between-	this i	rall and t	he W	all	
There			412	95	ndene dest	•		
333	26 > to me	ike The	YOOVA;	J 11	- Perlandia			

Remember: do not just draw the architectural feature in isolation. Show how it relates to surrounding features and include details of surface treatments, repairs/modifications/damage, bonding material(s), and associated cuts. Annotate all aspects of the feature or use a Drawing Key. Measurements must be included for all aspects of the feature and surrounding features.

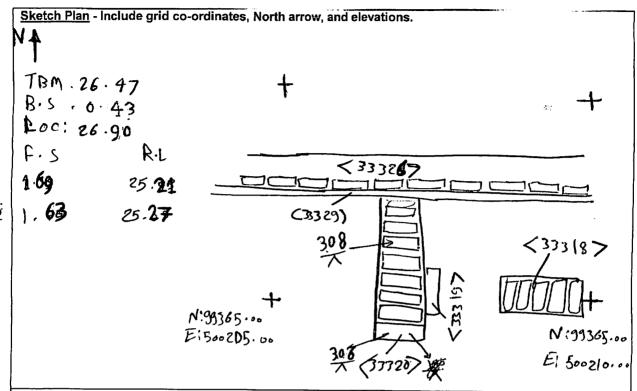

<u>Profile</u> Sketch - State direction the elevation of the feature being drawn is facing e.g. 'West Facing Elevation of Feature .... If feature was drawn in section then include the grid co-ordinates and elevations.

Drawing No.'s: '2012-1	Photo No.'s: 512468,512469			
Space No.: 11291-11294-11294	Structure No.: House C			
flatrix Group:	Matrix Phase:			