
AREA:	GRID SQUARE (S):		RDINATES:		INITIALS & DAT	ΓE:	FEATURE No.:
LICK CH	H1F 46	E			AKOA		
KKT-ET		N			9 March 2	olZ	3343
FEATURE T	YPE (For example wa	II, staircase,	bench, found	ation	Full extent visil	ole in p	lan:
structure, platform etc.):						ES /	NO
1. Dimensio		Width		Heigh			
		Length:	m Elm 1-89m N/S 0.75m				
	naterial(s) used						
	(form of construction	1)			_		·
4. Orientation							
5. Associate	·						
6. Cut & fill	feature #'s						
7. Repaired	?						
8. Associate	ed floors						
9. Surface to paint, mould	reatments? E.g. plast dings	er,					
10. Size of one component							
11. Bonding	material						
12. Excavate	ed	Yes/No			<del></del>		
Mini stratigr	aphic matrix		Abuts:		Same a	ıs:	
	33820		Abutted by	:	Associ	ated fe	atures:
	33439		Bonded int	o:			
NFE			Contiguous with:				
Discussion	and interpretation:		J	<del></del>			
	marl	bricks	unded	silo	in space	e 11'	237
<u> </u>							
							1
							ļ

Remember: do not just draw the architectural feature in isolation. Show how it relates to surrounding features and include details of surface treatments, repairs/modifications/damage, bonding material(s), and associated cuts. Annotate all aspects of the feature or use a Drawing Key. Measurements must be included for all aspects of the feature and surrounding features.

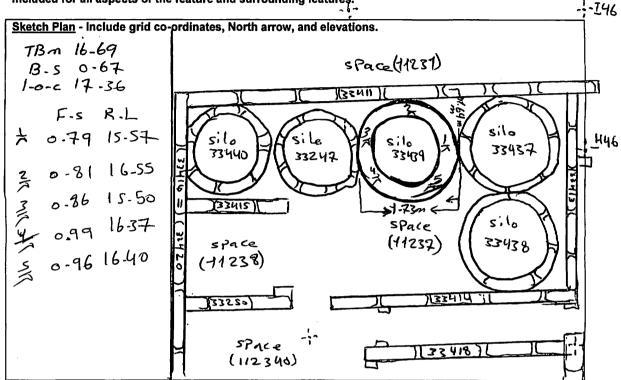

<u>Profile</u> Sketch - State direction the elevation of the feature being drawn is facing e.g. 'West Facing Elevation of Feature .... If feature was drawn in section then include the grid co-ordinates and elevations.

Drawing No.'s:	Photo No.'s:			
Space No.: 11237	Structure No.:			
Matrix Group:	Matrix Phase:			