


AREA: KKT.N	GRID SQUARE (S): 201 E11 201 F11	GRID CO-ORDINATES: E N	INITIALS & DATE: MFNH 25 ii 2012	FEATURE No.: 33533
----------------	--	------------------------------	--	-----------------------

FEATURE TYPE (For example wall, staircase, bench, foundation structure, platform etc.): threshold	Full extent visible in plan: <input checked="" type="radio"/> YES / NO
---	---

1. Dimensions (in metres)	Length: 0.80 m	Width: 0.30 m	Height: 0.10 m
2. Type of material(s) used	mudbrick		
3. Coursing (form of construction)	One Course		
4. Orientation	N-S		
5. Associated collapse	—		
6. Cut & fill feature #'s	—		
7. Repaired?	—		
8. Associated floors	—		
9. Surface treatments? E.g. plaster, paint, mouldings	—		
10. Size of one component	0.30 m by 0.20 m		
11. Bonding material	Sandy silt		
12. Excavated	<input checked="" type="radio"/> Yes / <input type="radio"/> No		

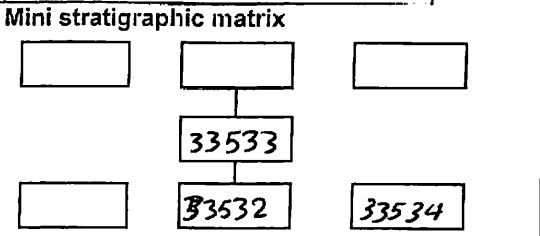

Abuts: ~~<33534>~~ ~~<33532>~~ Same as:

Abutted by: Associated features:

Bonded into:

Contiguous with:

Discussion and interpretation:


it is a threshold of mudbrick (N-S), it measures 0.80 m by 0.30 m. it consists of one course stretchers, it abuts the two door jams <33532>, <33534>. it is located ~~be~~ at the ~~not~~ western end of the main northern street.

It seems to be ~~our~~ threshold of a control entrance, to allow the inhabitants to go in and out of the purification (wcbt) house. ~~area~~ of ~~the~~ Khentekaus Temple cut.


Remember: do not just draw the architectural feature in isolation. Show how it relates to surrounding features and include details of surface treatments, repairs/modifications/damage, bonding material(s), and associated cuts. Annotate all aspects of the feature or use a Drawing Key. Measurements must be included for all aspects of the feature and surrounding features.

Sketch Plan - Include grid co-ordinates, North arrow, and elevations.

TBM . 26.47
 BS . 0.43
 Loc . 26.90

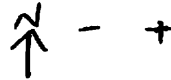

FS RL.
 $\frac{319}{X}$ 153 25.87

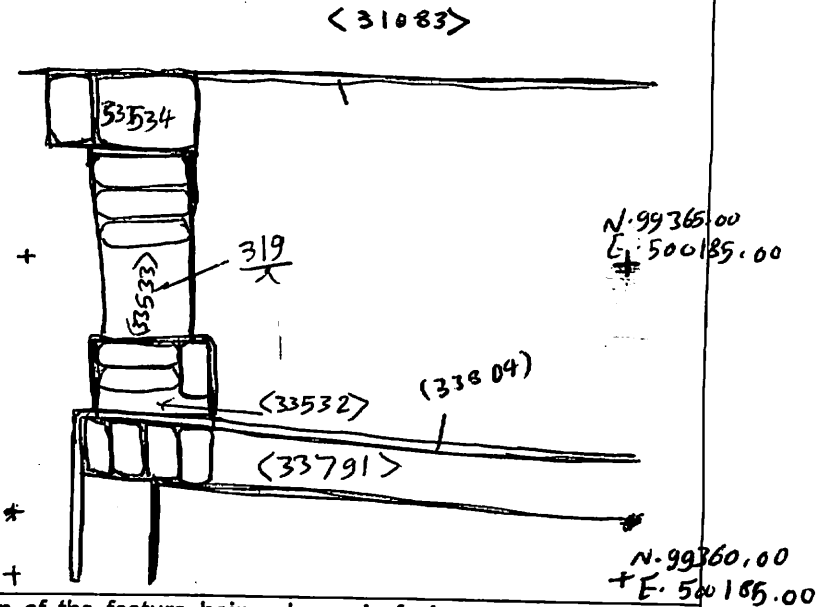

Profile Sketch - State direction the elevation of the feature being drawn is facing e.g. 'West Facing Elevation of Feature If feature was drawn in section then include the grid co-ordinates and elevations.

Drawing No.'s: 2012-4	Photo No.'s: 51315
Space No.: -	Structure No.: house (A).
Matrix Group:	Matrix Phase: 6
Samples taken:	