


AREA: KKT-N	GRID SQUARE (S): 201 D13	GRID CO-ORDINATES: E N	INITIALS & DATE: MFH 25 11 2012	FEATURE No.: 33793
----------------	-----------------------------	------------------------------	---------------------------------------	-----------------------

FEATURE TYPE (For example wall, staircase, bench, foundation structure, platform etc.): blocking event	Full extent visible in plan: <input checked="" type="radio"/> YES / NO
--	---

1. Dimensions (in metres)	Length: 0.60m	Width: 0.55 m	Height: 0.15 m
2. Type of material(s) used	mudbrick		
3. Coursing (form of construction)	two courses		
4. Orientation	N - S		
5. Associated collapse	—		
6. Cut & fill feature #'s	—		
7. Repaired?	—		
8. Associated floors	—		
9. Surface treatments? E.g. plaster, paint, mouldings	—		
10. Size of one component	0.40 m by 0.20 m		
11. Bonding material	sandy silt		
12. Excavated	Yes <input checked="" type="radio"/> No		

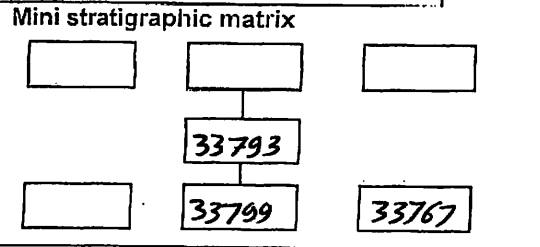

Abuts: ~~(33799)~~ ~~(33767)~~ Same as:

Abutted by: Associated features:

Bonded into:

Contiguous with:

Discussion and interpretation:
 it is a mudbrick blocking event, it measure 0.60m by 0.55 m, it consists of two courses, the eastern one is headers, the western one is stretcher but, there is a large limestone block inside it as a support for the blocking. it is located between the spaces (11315, 11316).



Remember: do not just draw the architectural feature in isolation. Show how it relates to surrounding features and include details of surface treatments, repairs/modifications/damage, bonding material(s), and associated cuts. Annotate all aspects of the feature or use a Drawing Key. Measurements must be included for all aspects of the feature and surrounding features.

Sketch Plan - Include grid co-ordinates, North arrow, and elevations.

TBM. 26.47
 BS. 2.42
 Loc. 28.89

Fs. RL.

~~81~~
 2.73 26.16

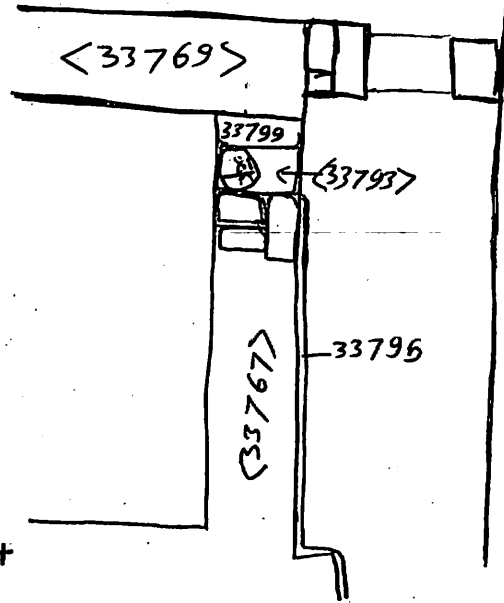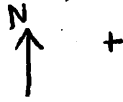

N. 99360.00
 E. 540195.00

N. 99355.00
 E. 540195.00

Profile Sketch - State direction the elevation of the feature being drawn is facing e.g. 'West Facing Elevation of Feature If feature was drawn in section then include the grid co-ordinates and elevations.

Drawing No.'s: 2012-4	Photo No.'s: 313119
Space No.: 11315, 11316	Structure No.: house (4)
Matrix Group:	Matrix Phase: 6
Samples taken:	