
	AREA:	GRID SQUARE (S):	GRID CO	O-ORDINATES:	<del></del>	INITIALS & DA	ATE:	FEATURE No.:
	KKT.N	201 E12	N'					33801
	FEATURE T	YPE (For example wa	li, staircas	e, bench, found	lation	Full extent vis	ible in n	lan'
	structure, pl	latform etc.):	J			Y	'ES /(i	<u> </u>
	1. Dimension	ns (in metres)	Lengt	h:	Width		Heigh	nt:
			01	55M	0.	Zo M	0,0	5m
		aterial(s) used	Mu	1d Brick	<		<u> </u>	
	3. Coursing (	form of construction	oh	e unit n	nud f	SVICA		
	4. Orientation	· · · · · · · · · · · · · · · · · · ·	1	W				
1	5. Associated	collapse					·	
	6. Cut & fill fe	eature #'s	<del>  _</del>			<del></del>	<del></del>	
	7. Repaired?							
$\int$	8. Associated	floors						
t	9. Surface trea	atments? E.g. plaster,						
	paint, mouldir	ngs	_	<del></del>				
ľ	10. Size of one	component		****				
ŀ	11. Bonding m	natorial	0.05	5. Long 1	29 0	s. Zomuldet	-h	
L		· .	Sail	tiz ebr	t		•	
l	12. Excavated		Yes/No	Notex	Call	2 + 0 )	······	
r	Mini stratigrap	hic matrix	1	Notex Abuts: <3	37.0	Same a	 s:	
				Abutted by:	3 <b>4</b> 8	5 T		
		333801		Bonded into:		Associa	ted feat	ures:
	<del></del>			Comtinue				
		33486		Contiguous v	vitn:	•		
C	iscussion and	l interpretation:		<del></del>	<del></del>			
	_							
	E-W	mud Brick d	wor ja	mp abut	S <3	34867 loca	ited 4	a fika
	northe	in west to space	e 113	20 .		,		o the
		•	,,,,,					
	,							
		•					•	
								1
				•		,		
								}
								. [
								}

\*\*\*\* FO FOUR MEDOLING FORM

Remember: do not just draw the architectural feature in isolation. Show how it relates to surrounding features and include details of surface treatments, repairs/modifications/damage, bonding material(s), and associated cuts. Annotate all aspects of the feature or use a Drawing Key. Measurements must be included for all aspects of the feature and surrounding features.

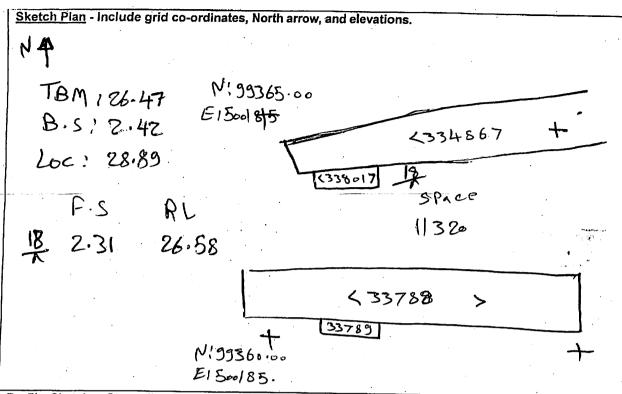

Profile Sketch - State direction the elevation of the feature being drawn is facing e.g. West Facing Elevation of Feature .... If feature was drawn in section then include the grid co-ordinates and elevations.

Drawing No.'s: 8/2-4	Photo No.'s: 5/3/73-5/3/15-5/3/16  Structure No.: House A				
Space No.: 11320					
Matrix Group:	Matrix Phase: 4b				