
AREA:	GRID SQUARE (S):	GRID CO	-ORDINATES:		INITIAL	S & DA	ΓE:	FEATURE No.	
1	8140	E			AFA	M		1 11 110.	
KKT.N		N		1		26 12		33881	
FEATURE T	YPE (For example wa	II, staircas	e, bench, found	lation	Full ext		de in p	•	
structure, pl	latform etc.): Wall	<del>-</del>				•		•	
1 Dimension	ns (in metres)	I am mái	·	140.141	<u>·</u>	1.5	<u>s</u> / !		
	no (m medes)		Length: Width: 0.90			j	Height:		
2. Type of m	aterial(s) used		mudbrick				0.0	3	
	(form of construction)	)			<u>-</u>				
		2 Co	2 Courses						
4. Orientation	n	E.	E-W						
5. Associated	collapse								
6. Cut & fill fe	eature #'s		•				<del></del> -	·	
7 Danain IO			<u> </u>	· · · · · · · · · · · · · · · · · · ·					
7. Repaired?	•								
8. Associated	floors	_	<u> </u>						
	atments? E.g. plaster,	<del> </del>	<del></del>						
paint, mouldir	ngs	_	_					·	
10. Size of one	component	0.40	m x 0 19	m	· · · · • • • • • • • • • • • • • • • •		·		
11. Bonding m	naterial	<del> </del>	dy silt						
12. Excavated	· · · · · · · · · · · · · · · · · · ·	Yes/No	9) 2(1)		<del></del>				
Mini stratigrap	hic matrix		Abuts: <33	0 2 7 .					
- Toracigrap		<del></del> 7	Abuts: <53	0 7 7 >	, 5	Same as:	:		
<u> </u>			Abutted by:		A	ssociate	ed feat	ures:	
•	<b>433881&gt;</b>		Bonded into:						
	33877		Contiguous v	vith:					
	interpretation:								
wall (3	3881> is Etc	wmu	dbrickwa	ell · T	he top	of th	iswa	all consist	
of two	Courses . Then	orthern.	and the sou	Mern	side is	haa	1010	11	
abutes	wall (33877	z > .			J, 4C 1 J	חבמנ	ser.	The wall	
	• 37671								
								. ]	
								1	
				•					
		·							

----- ---- NEOONDING FURI

Remember: do not just draw the architectural feature in isolation. Show how it relates to surrounding features and include details of surface treatments, repairs/modifications/damage, bonding material(s), and associated cuts. Annotate all aspects of the feature or use a Drawing Key. Measurements must be included for all aspects of the feature and surrounding features.

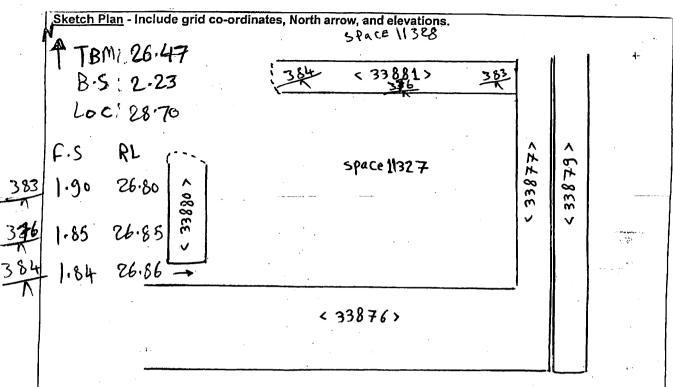

Profile Sketch - State direction the elevation of the feature being drawn is facing e.g. West Facing Elevation of Feature .... If feature was drawn in section then include the grid co-ordinates and elevations.

Drawing No.'s: 2012-18	Photo No.'s: 513 209 - 513 210				
Space No.: 11327 - 11328	Structure No.: magasines				
Matrix Group:	Matrix Phase: 4-B				