
AREA:	GRID SQUARE (S):	GRID CO-0	ORDINATES:	INITIALS & DA	TE:	FEATURE No.:	
kkt_e+	1+46	E			A160 A HMarch 2012 34027		24027
,		N			11/March	2012	34027
FEATURE T	YPE (For example wa	ll, staircase,	bench, found	lation	Full extent visi		
	latform etc.):		·			·	
				,. <u> </u>		ES / I	NO
1. Dimensio	ns (in metres)	Length		Width		Heigh	
	·	0.46		0.3	3m	0 -	4850
	naterial(s) used						
	(form of construction	)	-	-			
4. Orientation	on	$\epsilon$	ast - we	st			
5. Associate	ed collapse						
6. Cut & fill f	eature #'s						
7. Repaired?	?				<del></del>		
8. Associate	d floors				<del></del>		
	eatments? E.g. plaste	r,					
paint, mould	lings	Ì					
10. Size of o	ne component						· · · · · · · · · · · · · · · · · · ·
11. Bonding	material						
12. Excavate	ed	Yes/No					
Mini stratigra	aphic matrix		Abuts: 33	: 418	Same a	s:	
34004			Abutted by: Associated features:				
34027			Bonded into:				
33418			Contiguous with:				
Discussion a	and interpretation:	<del></del>	<u> </u>				
			•				
	suls-rectang	Jular 1	nask boic	ck d	oor Jamb	(340	27)
	form the we	stra . (	· m; t cF	s Pa	ce (1/239)	)	
ŊF	form the we	s ren c	_,,,,,,				
							·
		<b>)</b>					
-							

Remember: do not just draw the architectural feature in isolation. Show how it relates to surrounding features and include details of surface treatments, repairs/modifications/damage, bonding material(s), and associated cuts. Annotate all aspects of the feature or use a Drawing Key. Measurements must be included for all aspects of the feature and surrounding features.

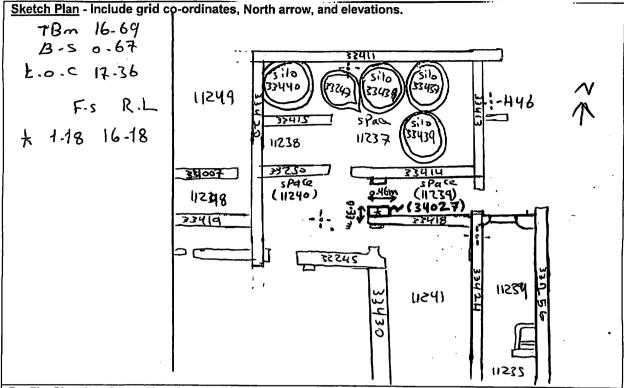

<u>Profile</u> Sketch - State direction the elevation of the feature being drawn is facing e.g. 'West Facing Elevation of Feature .... If feature was drawn in section then include the grid co-ordinates and elevations.

Drawing No.'s:	Photo No.'s:	
Space No.: 11239 , 1/240	Structure No.:	
Matrix Group:	Matrix Phase:	
Samples taken:		